
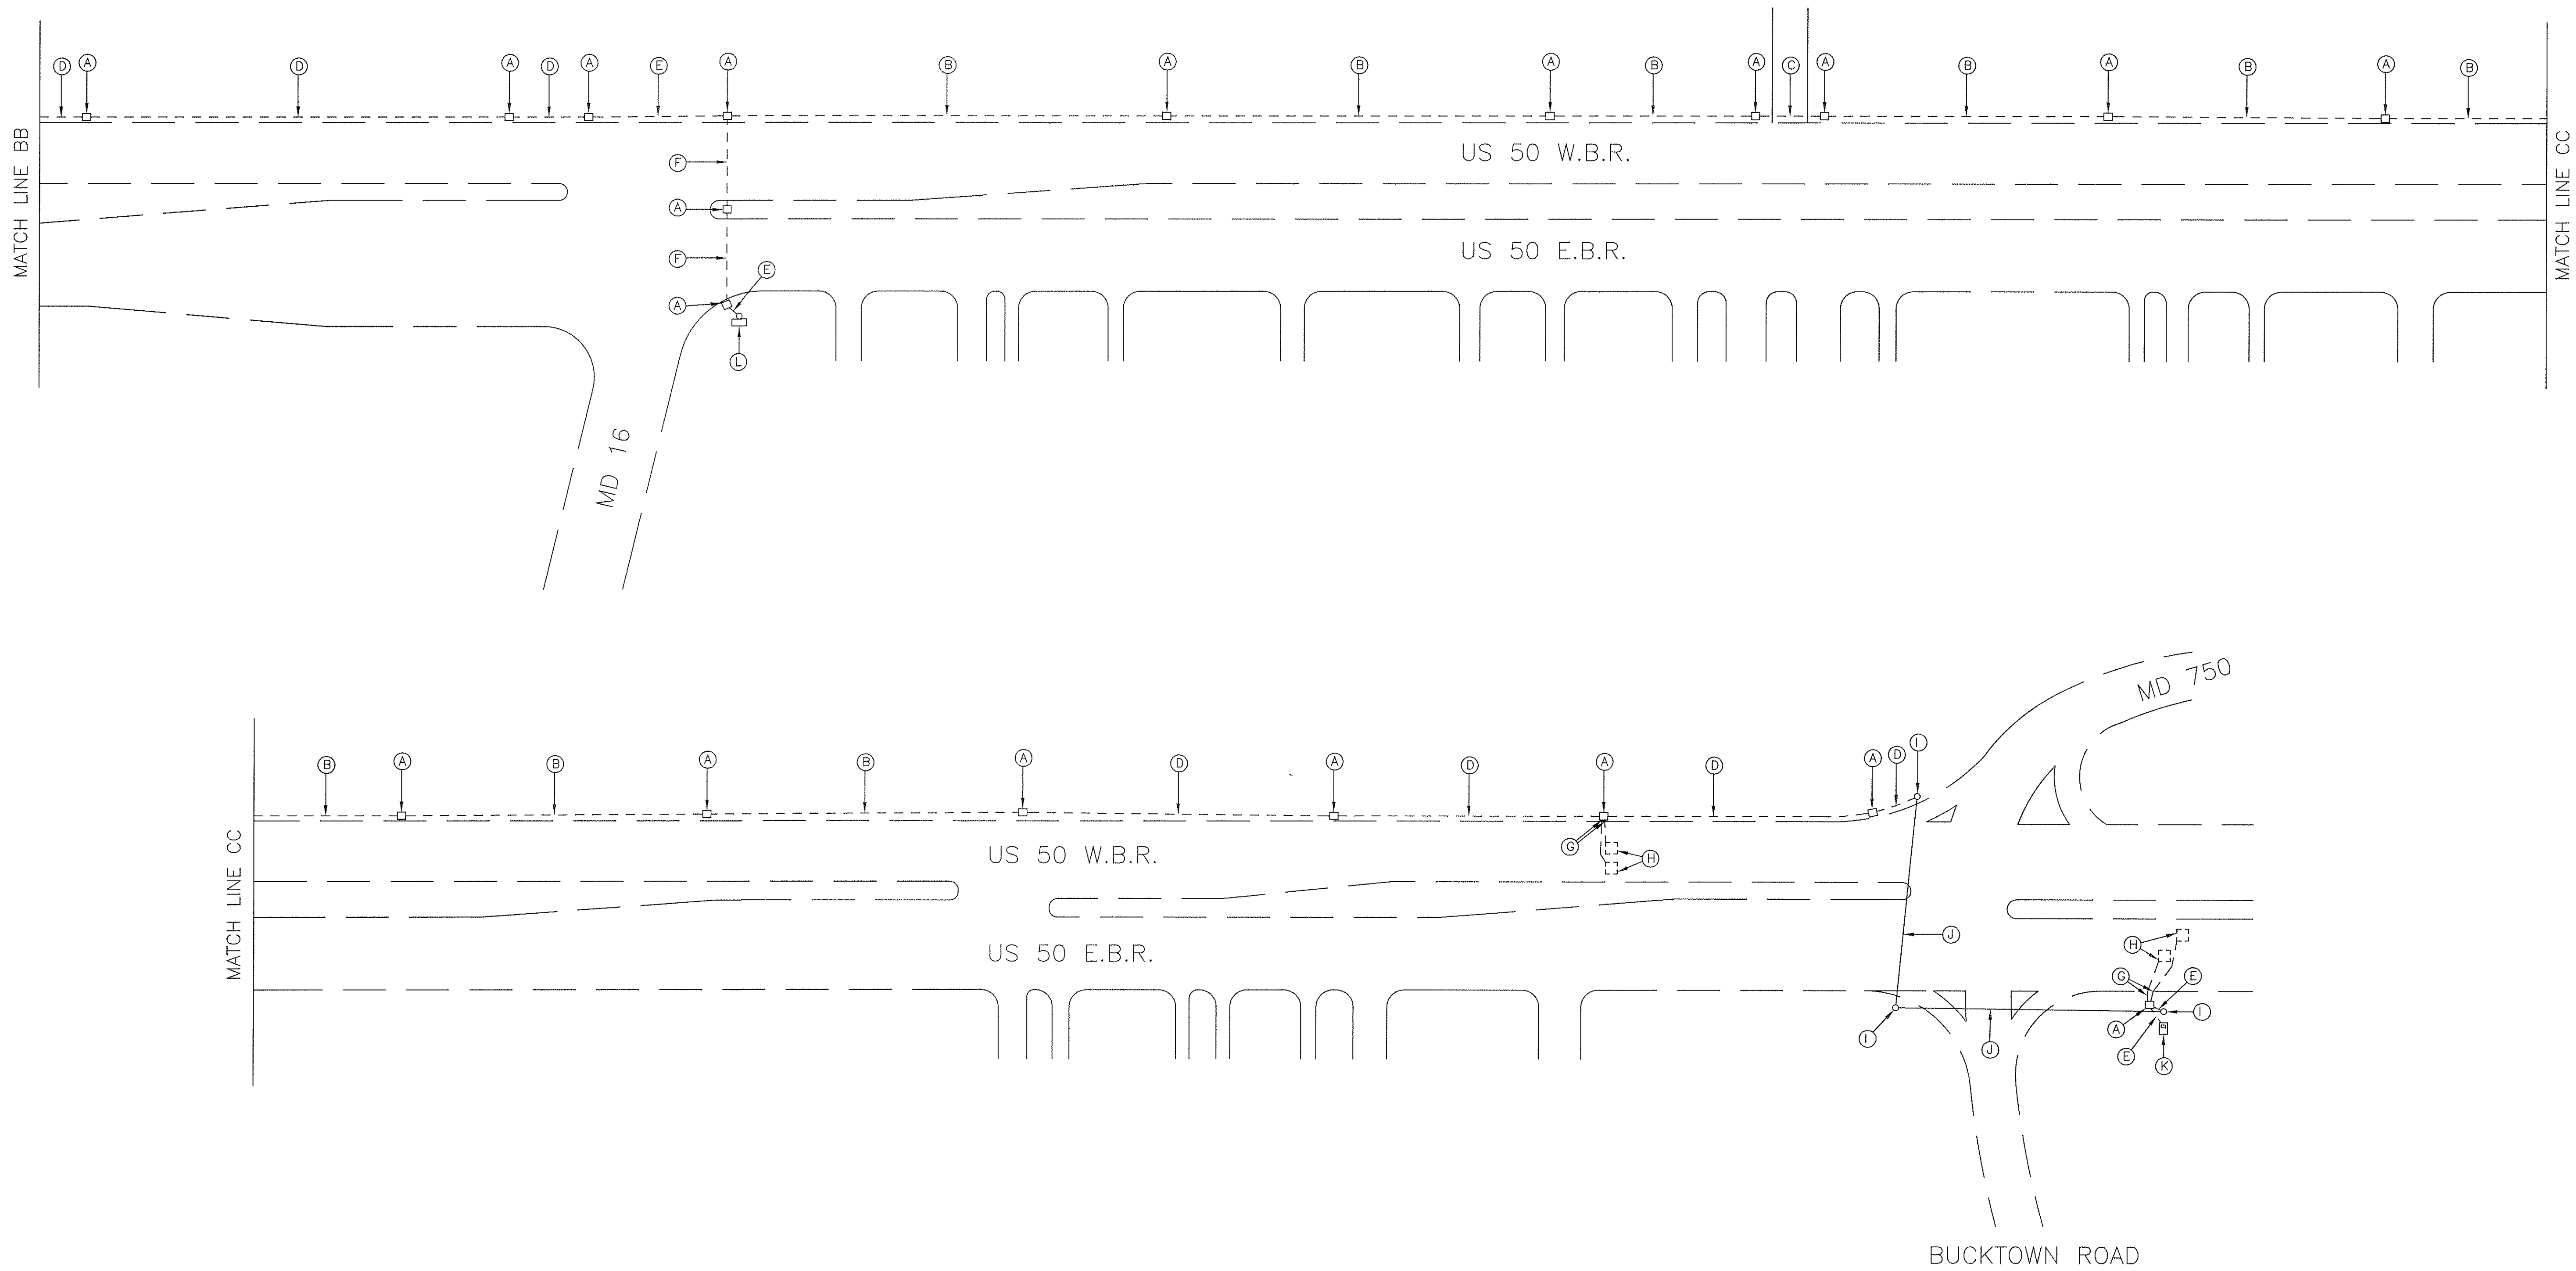



F H W A REGION NO.	STATE	FED. AID PROJ. NO.	SHEET NO.	TOTAL SHEETS
3	MD			

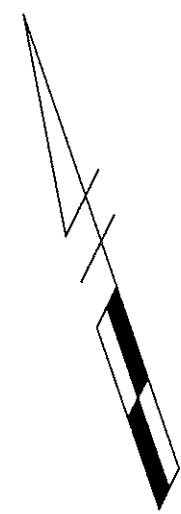

REVISIONS	APPROVALS	REVISIONS	<div>MARYLAND DOT – STATE HIGHWAY ADMINISTRATION Office of Traffic & Safety TRAFFIC ENGINEERING DESIGN DIVISION TRAFFIC SIGNALIZATION PLAN US 50 FROM WOODS ROAD TO BUCKTOWN ROAD</div>			
A 8-15-97 ASBUILT	ASSISTANT DIVISION CHIEF					
T/C	ASST. DISTRICT ENGINEER, TRAFFIC		DATE: 8-9-96	DRAWN BY: J. DIMAGGIO	F.A.P. NO.	PLAN SHEET NO.:
	CHIEF, TRAFFIC ENGINEERING DESIGN DIV.		SCALE: 1" = 50'	DESIGNED BY: T. ZAYDEL	S.H.A. NO.	SHEET NO. 3049X
	DIRECTOR, OFFICE OF TRAFFIC AND SAFETY		APPROVED BY:	CHECKED BY: T. HANNAN	COUNTY DORCHESTER	OF